




FRONT VIEW

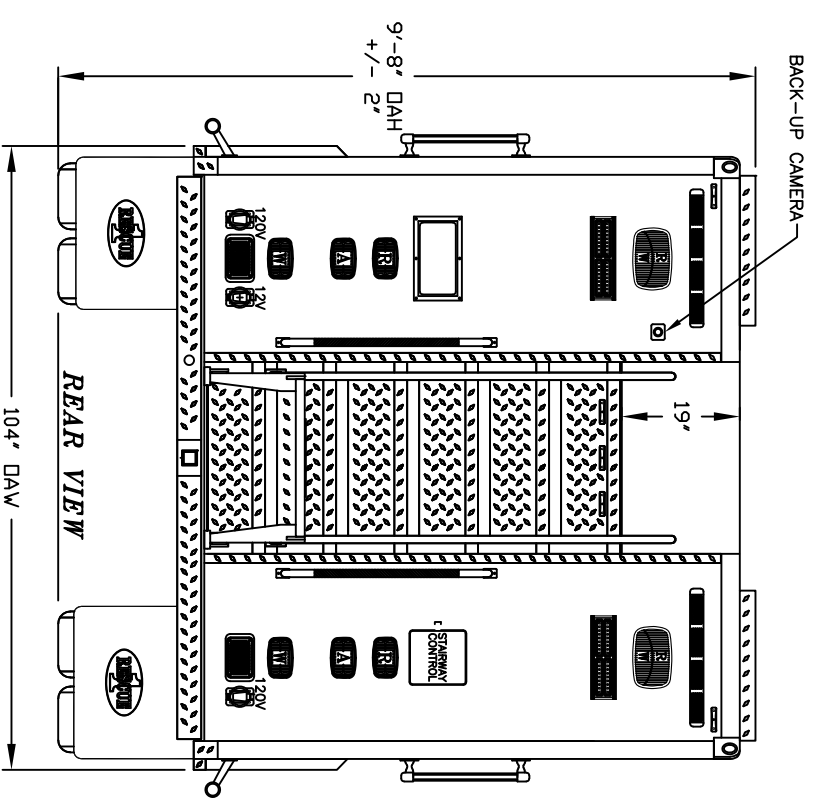

REAR VIEW

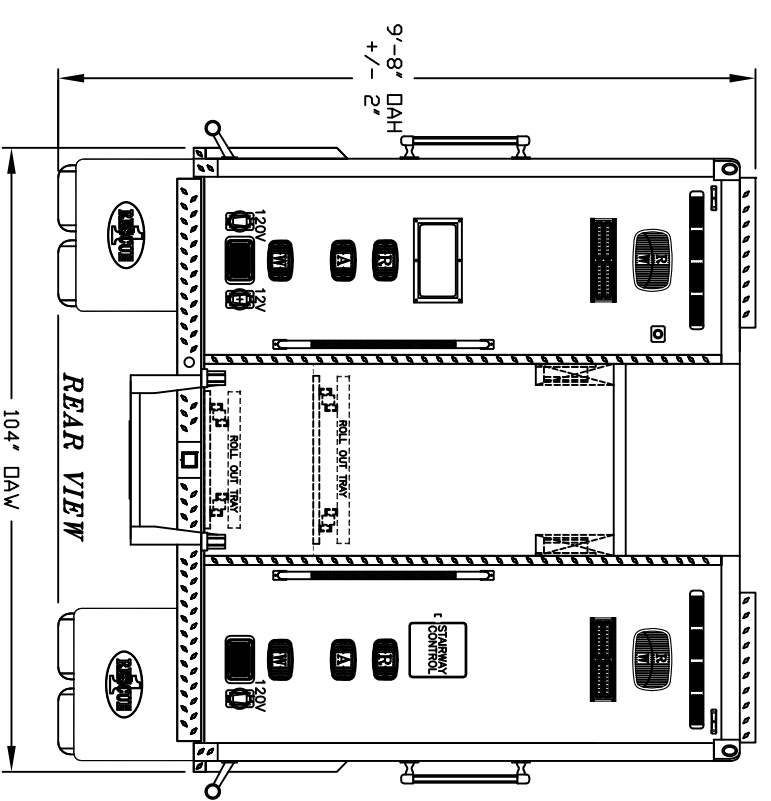

REAR VIEW

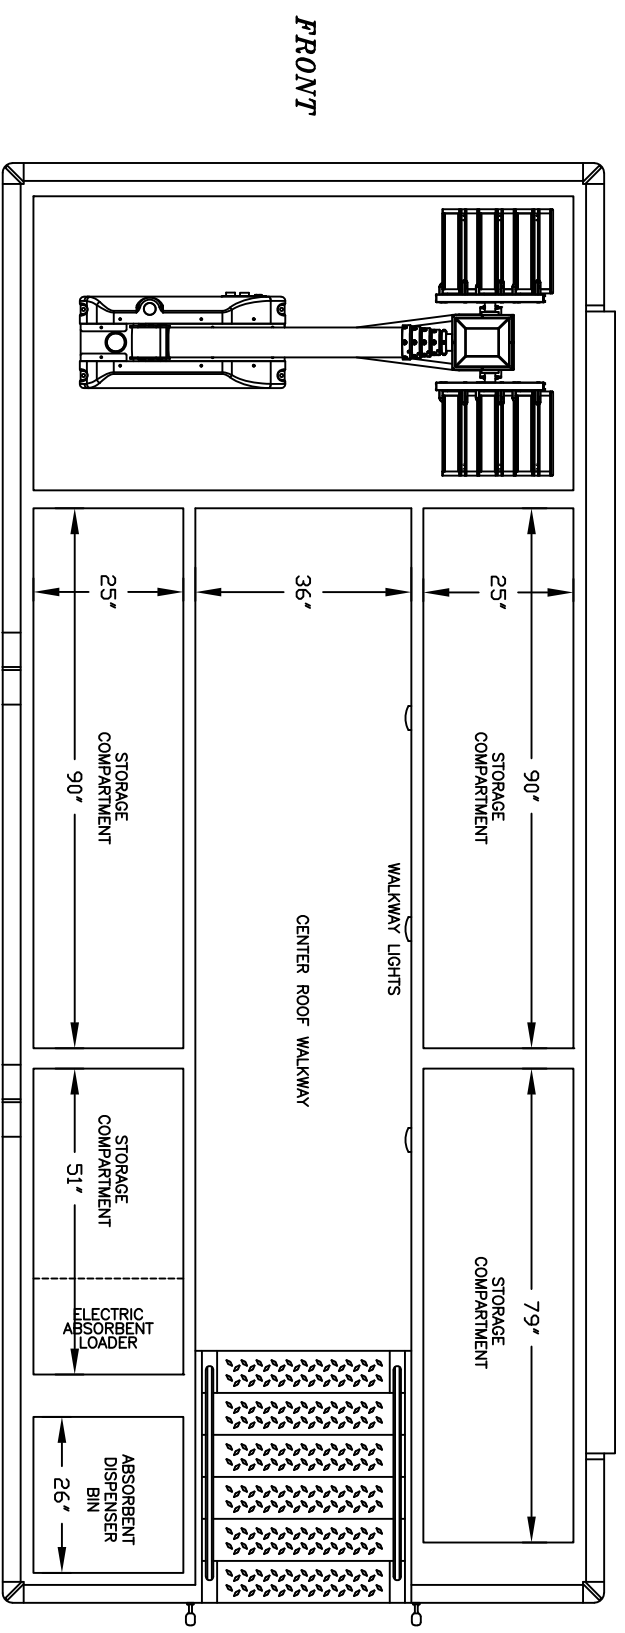

FRONT

ROOF VIEW

REAR

HEAVY RESCUE VEHICLE

CUSTOM DESIGNED FOR
RESCUE 1 2024 DEMO #1
 BY RESCUE 1


- NOTES:
1. DRAWINGS ARE FOR REPRESENTATIONAL PURPOSES ONLY.
 2. ALL DIMENSIONS ARE APPROXIMATE.
 3. COMPARTMENT DIMENSIONS REPRESENT THROUGH OPENINGS UNLESS OTHERWISE NOTED.
 4. ALL DIMENSIONS FOR OVERALL HEIGHT AND OVERALL LENGTH ARE APPROXIMATE UNTIL THE CHASSIS IS BUILT AND RECEIVED AT OUR FACTORY.


REV	QW #	DATE	BY	APP'D	REVISIONS
C	0004	02-26-24	SD	-	
B	0003	06-16-23	DP	-	
A	0002	05-02-23	RAE	-	
REV	QW #	DATE	BY	APP'D	REVISIONS


TITLE	HEAVY RESCUE VEHICLE
CUSTOMER	RESCUE 1 2024 DEMO #1
VEHICLE TYPE	THIS DRAWING MADE FROM REV./DATE
FORM #	DO NOT SCALE DRAWING
DRAWN	ROGER RITTER DATE 02-14-23
SCALE	3/4" = 1'-0" SHEET 2 OF 2
JOB #	R370 DWG 6227




NOTICE: THIS DRAWING IS UNCONTROLLED. ANY CHANGES TO THIS DRAWING MUST BE MADE ON A DISC DESIGNED TO OTHERS FOR PRODUCTION OR MANUFACTURING PURPOSES. EXCEPT AS OTHERWISE NOTED, ALL DIMENSIONS ARE APPROXIMATE. ALL DIMENSIONS FOR OVERALL HEIGHT AND OVERALL LENGTH ARE APPROXIMATE UNTIL THE CHASSIS IS BUILT AND RECEIVED AT OUR FACTORY. ALL DIMENSIONS SHALL BE IN INCHES UNLESS OTHERWISE SPECIFIED.

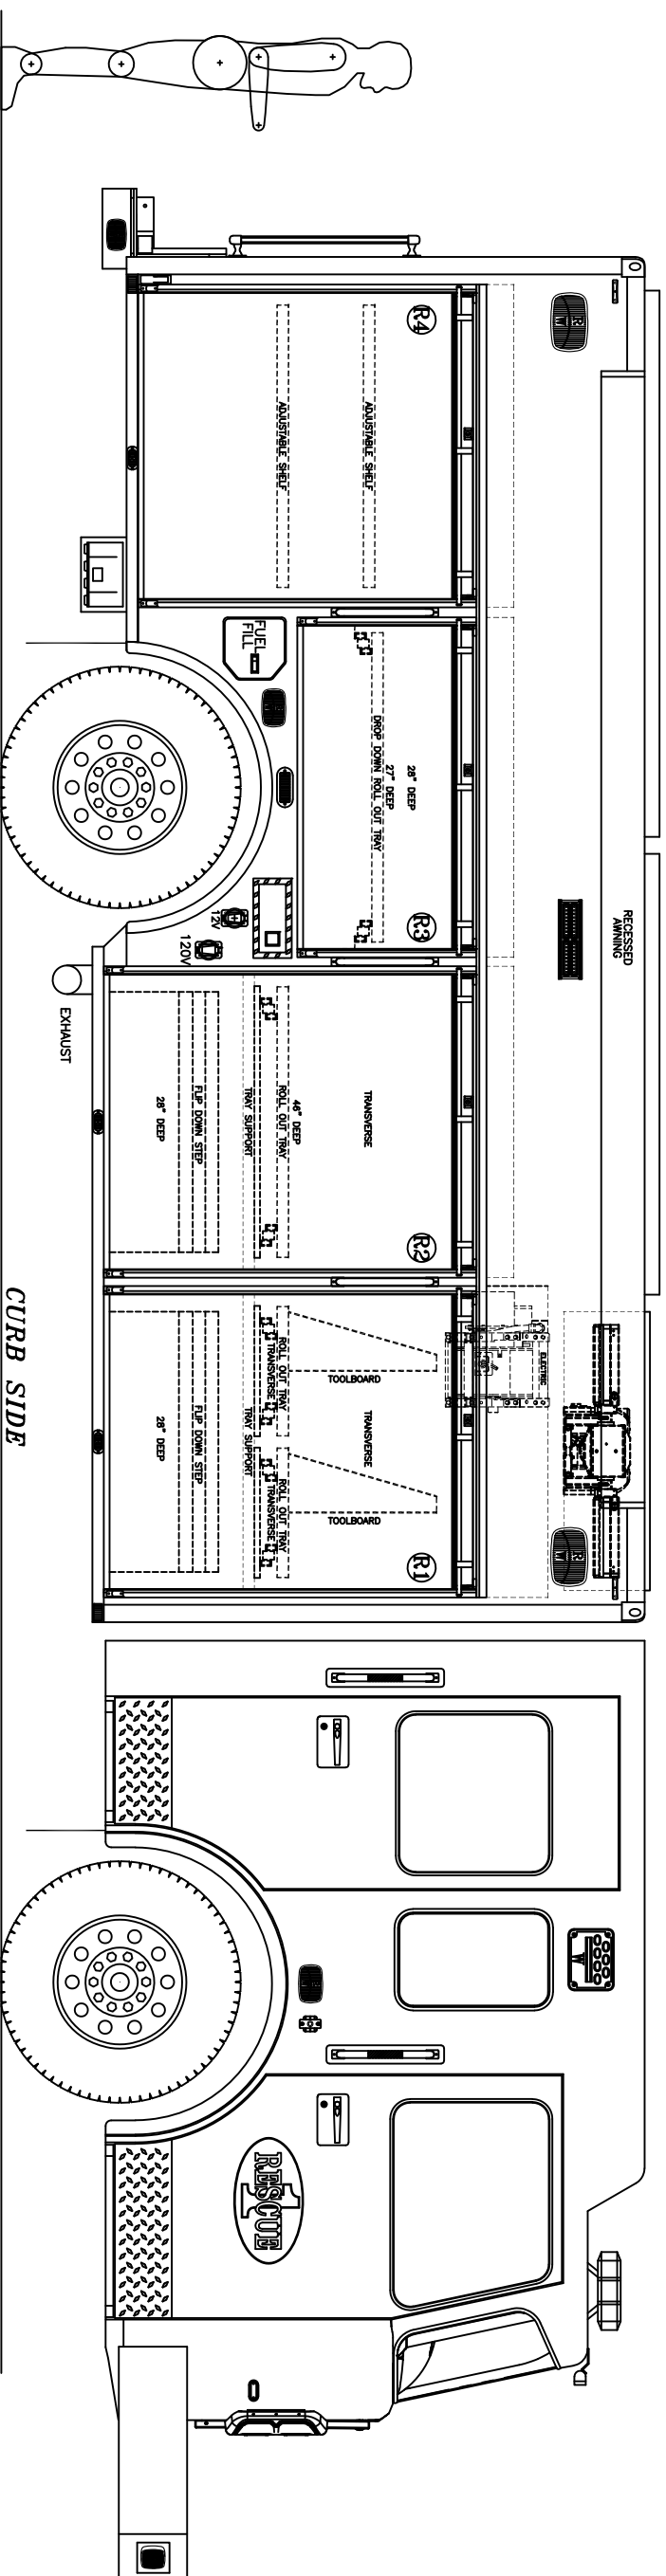

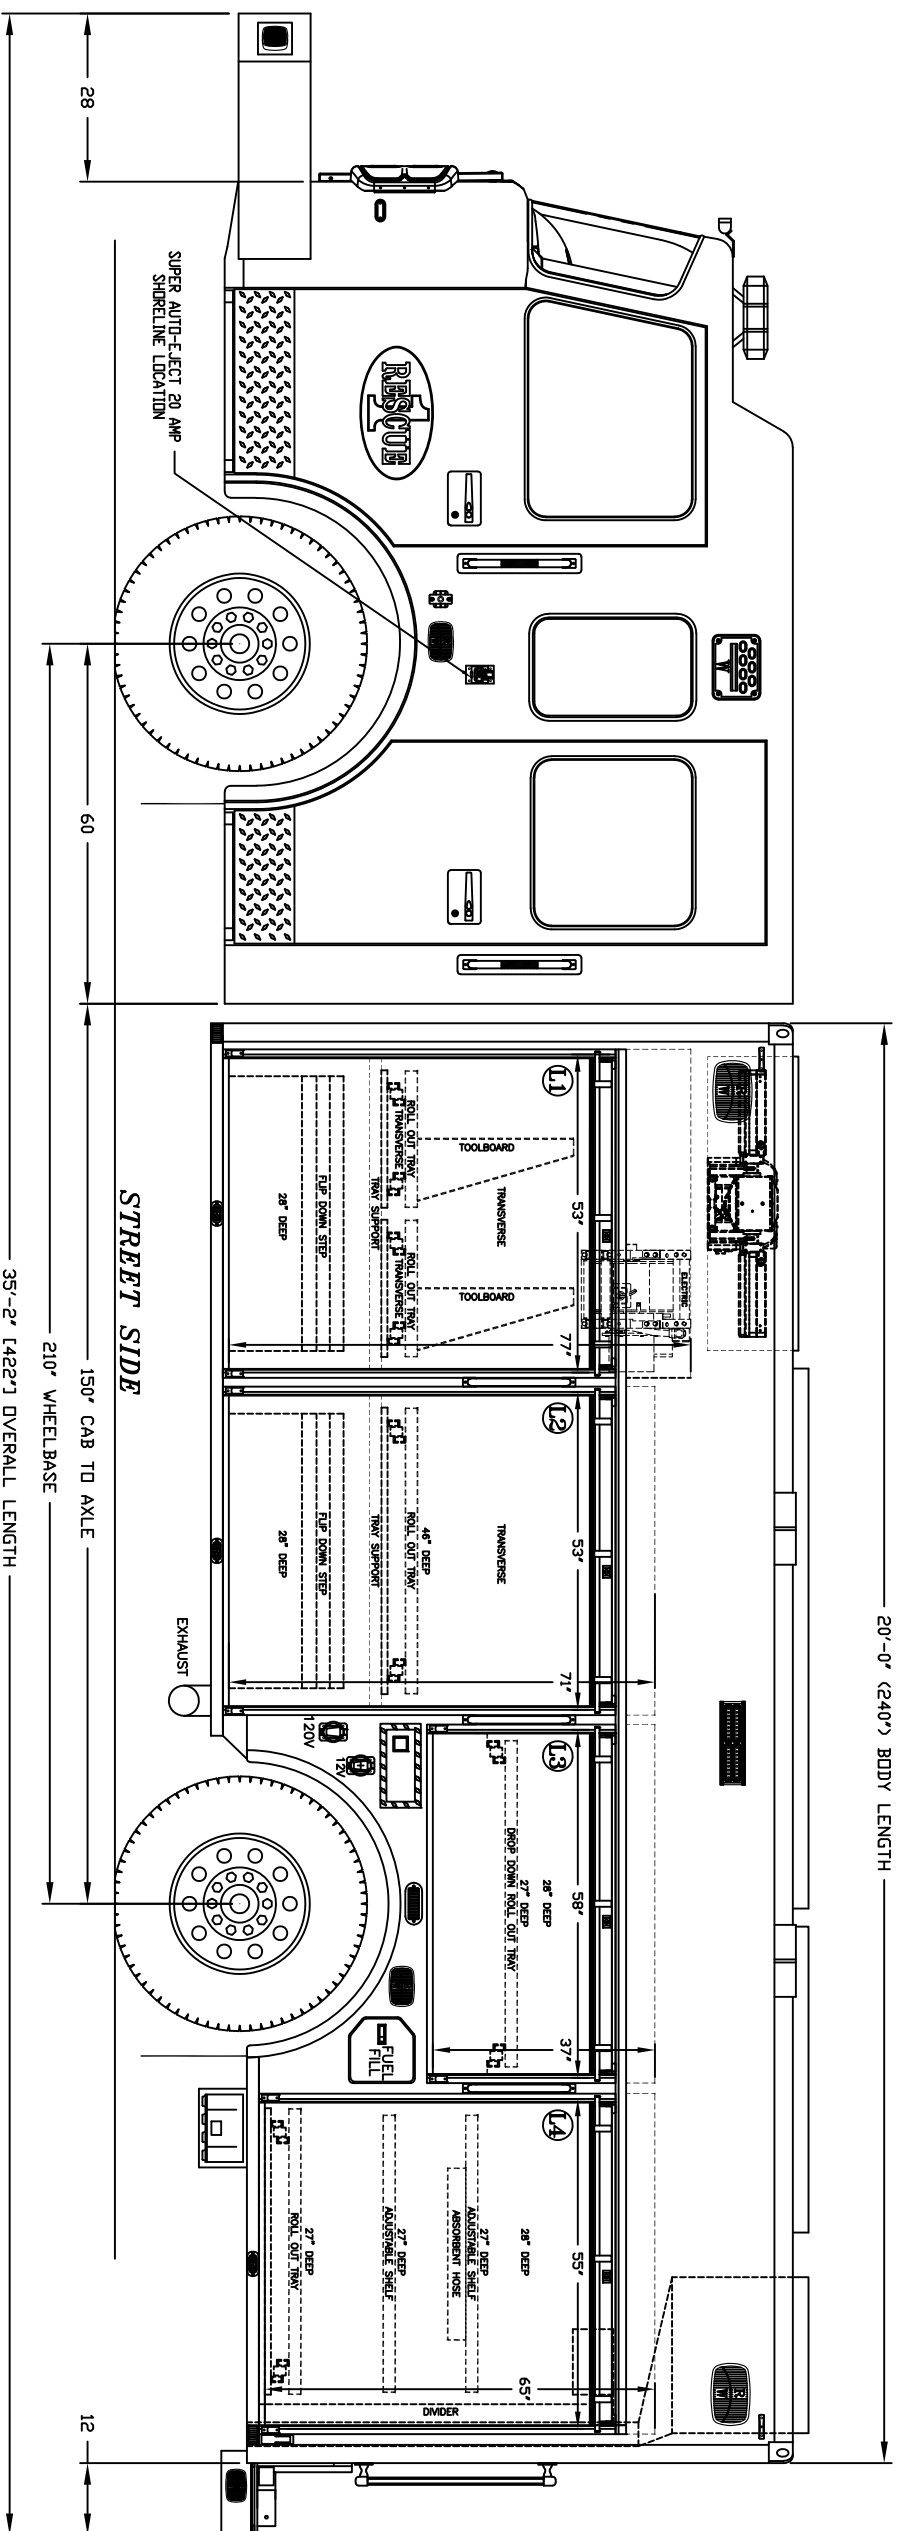

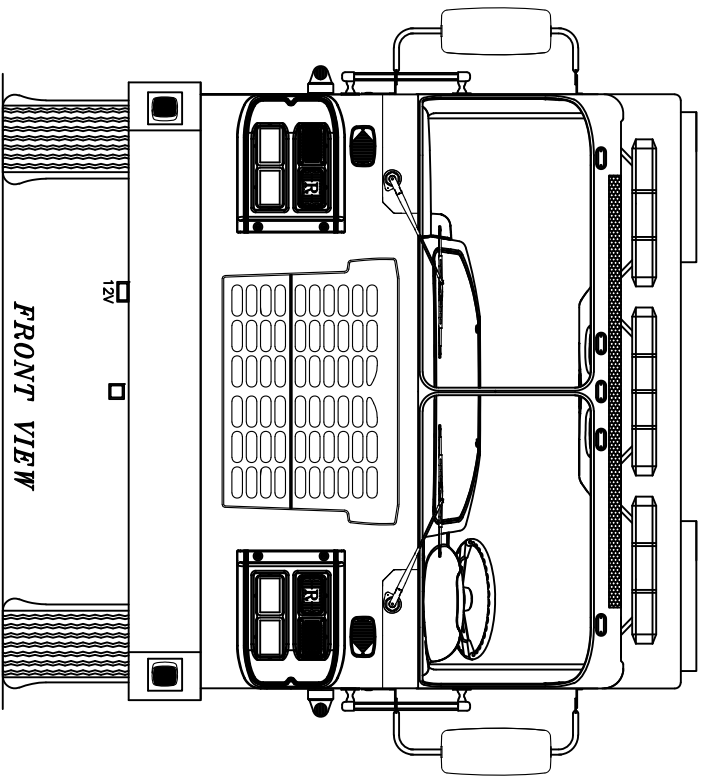

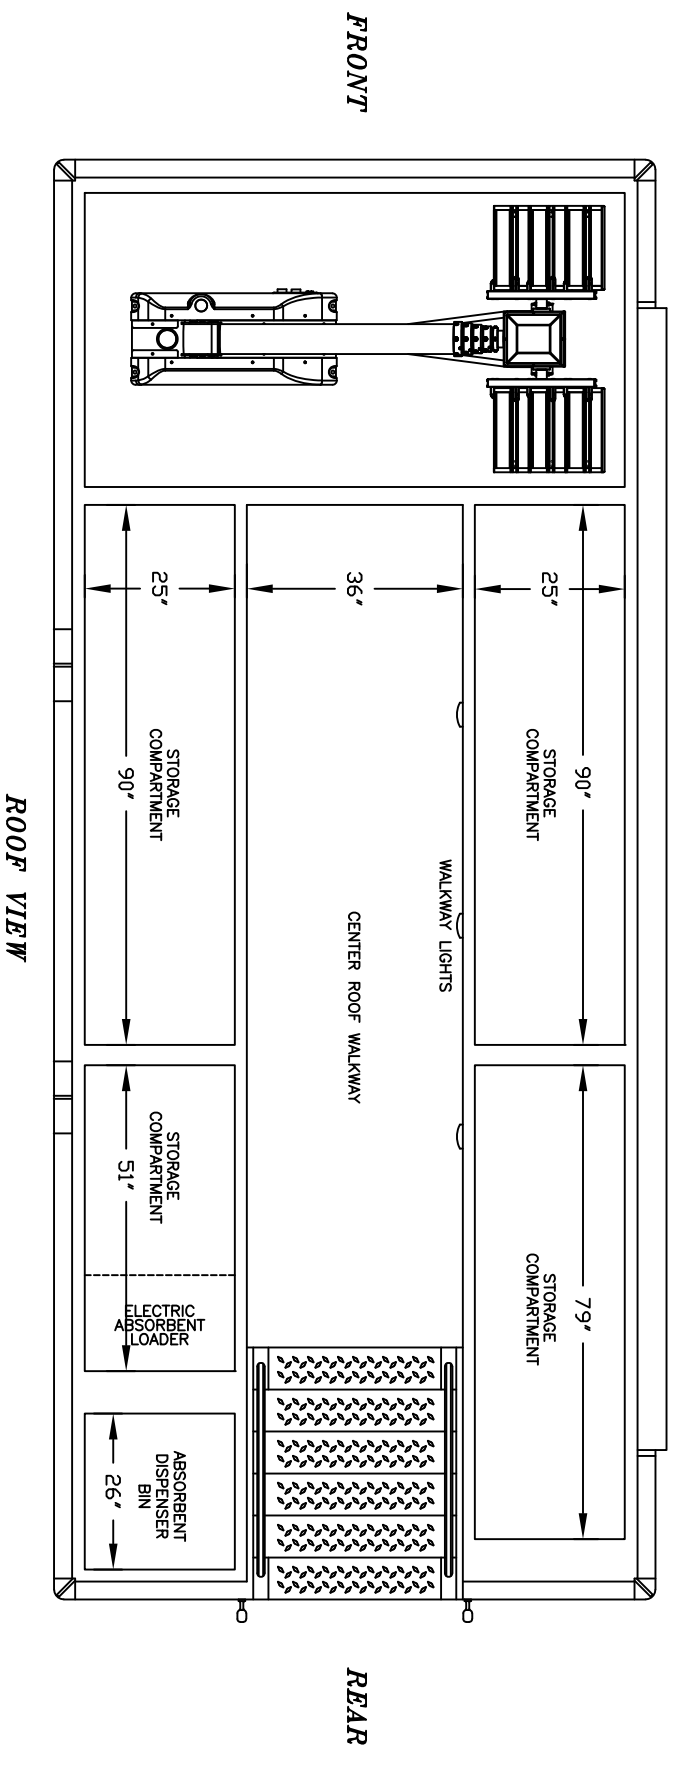

FRONT

REAR

ROOF VIEW